

Prepared by:	Paul Lorenz Olayvar	Title:	AMBS SYSTEM CONNECTION AS-BUILT PLAN	Date:	October 15, 2024
Checked by:	Ryan Christian Fabul	Company:	ADVANCED MEDIA BROADCASTING SYSTEM	Approved by:	Revision:


**NEW EQUIPMENT**  
INFORTREND STORAGE  
MGMT: 192.168.1.231  
FILESYSTEM: 192.168.1.232  
S/N: HSCS000A2403000030

**NEW EQUIPMENT**

Etere Transcoder  
(192.168.1.235)  
S/N: SGH401NW5V

SQL  
(192.168.1.230)  
S/N: SGH402F3SR

**EXISTING EQUIPMENT**  
XOS 1  
(192.168.1.183)  
S/N: E440801X1C04240

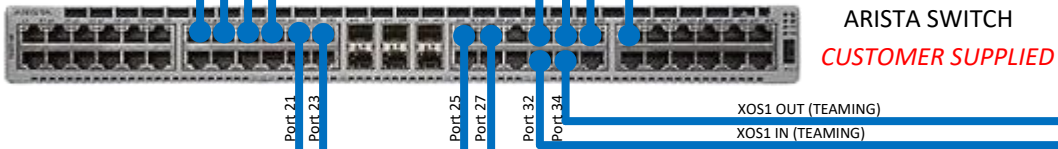


ETX2 Playout  
MGMT: 192.168.1.220  
UDP OUT: 192.168.2.224/VLAN20  
S/N: SGH240YC05  
**EXISTING EQUIPMENT**


**NEW EQUIPMENT**

Etere Scheduling and Executive Editor  
(192.168.1.236)  
S/N: 4CE401BYD1

Etere File Ingest  
(192.168.1.237)  
S/N: 4CE401BYD2

**LEGEND:**  
— LAN Cable

Prepared by: <b>Paul Lorenz Olayvar</b>	Title: <b>ETX NETWORK DIAGRAM</b>	 <b>MEDIA CONVERGENCE INC.</b>	Date: October 15, 2024
Checked by: <b>Ryan Christian Fabul</b>	Company: <b>ADVANCED MEDIA BROADCASTING SYSTEM</b>	Approved by: <b>AL Z. Banguilan</b>	Revision:

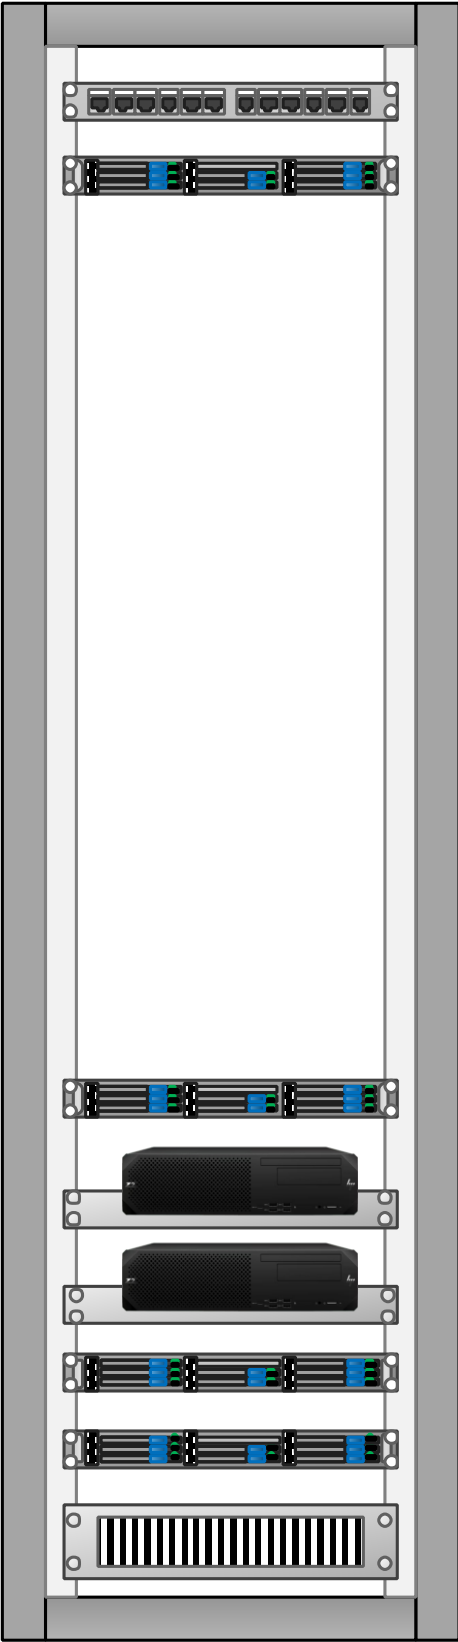

Patch Panel

XOS Encoder 1

ETX 2 Server


Etere Ingest



Etere Scheduling

SQL Server


Etere Transcoder

Infortrend Storage

Prepared by: <b>Paul Lorenz Olayvar</b>	Title: <b>RACK LAYOUT</b>	 <b>MEDIA CONVERGENCE INC.</b>	Date: October 15, 2024
Checked by: <b>Ryan Christian Fabul</b>	Company: <b>ADVANCED MEDIA BROADCASTING SYSTEM</b>	Approved by:	Revision:

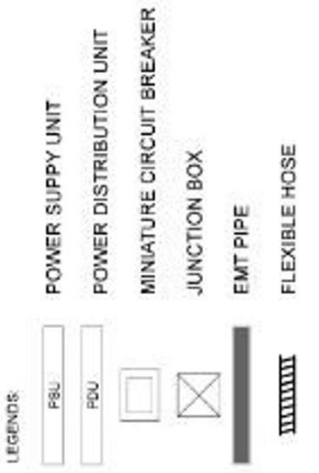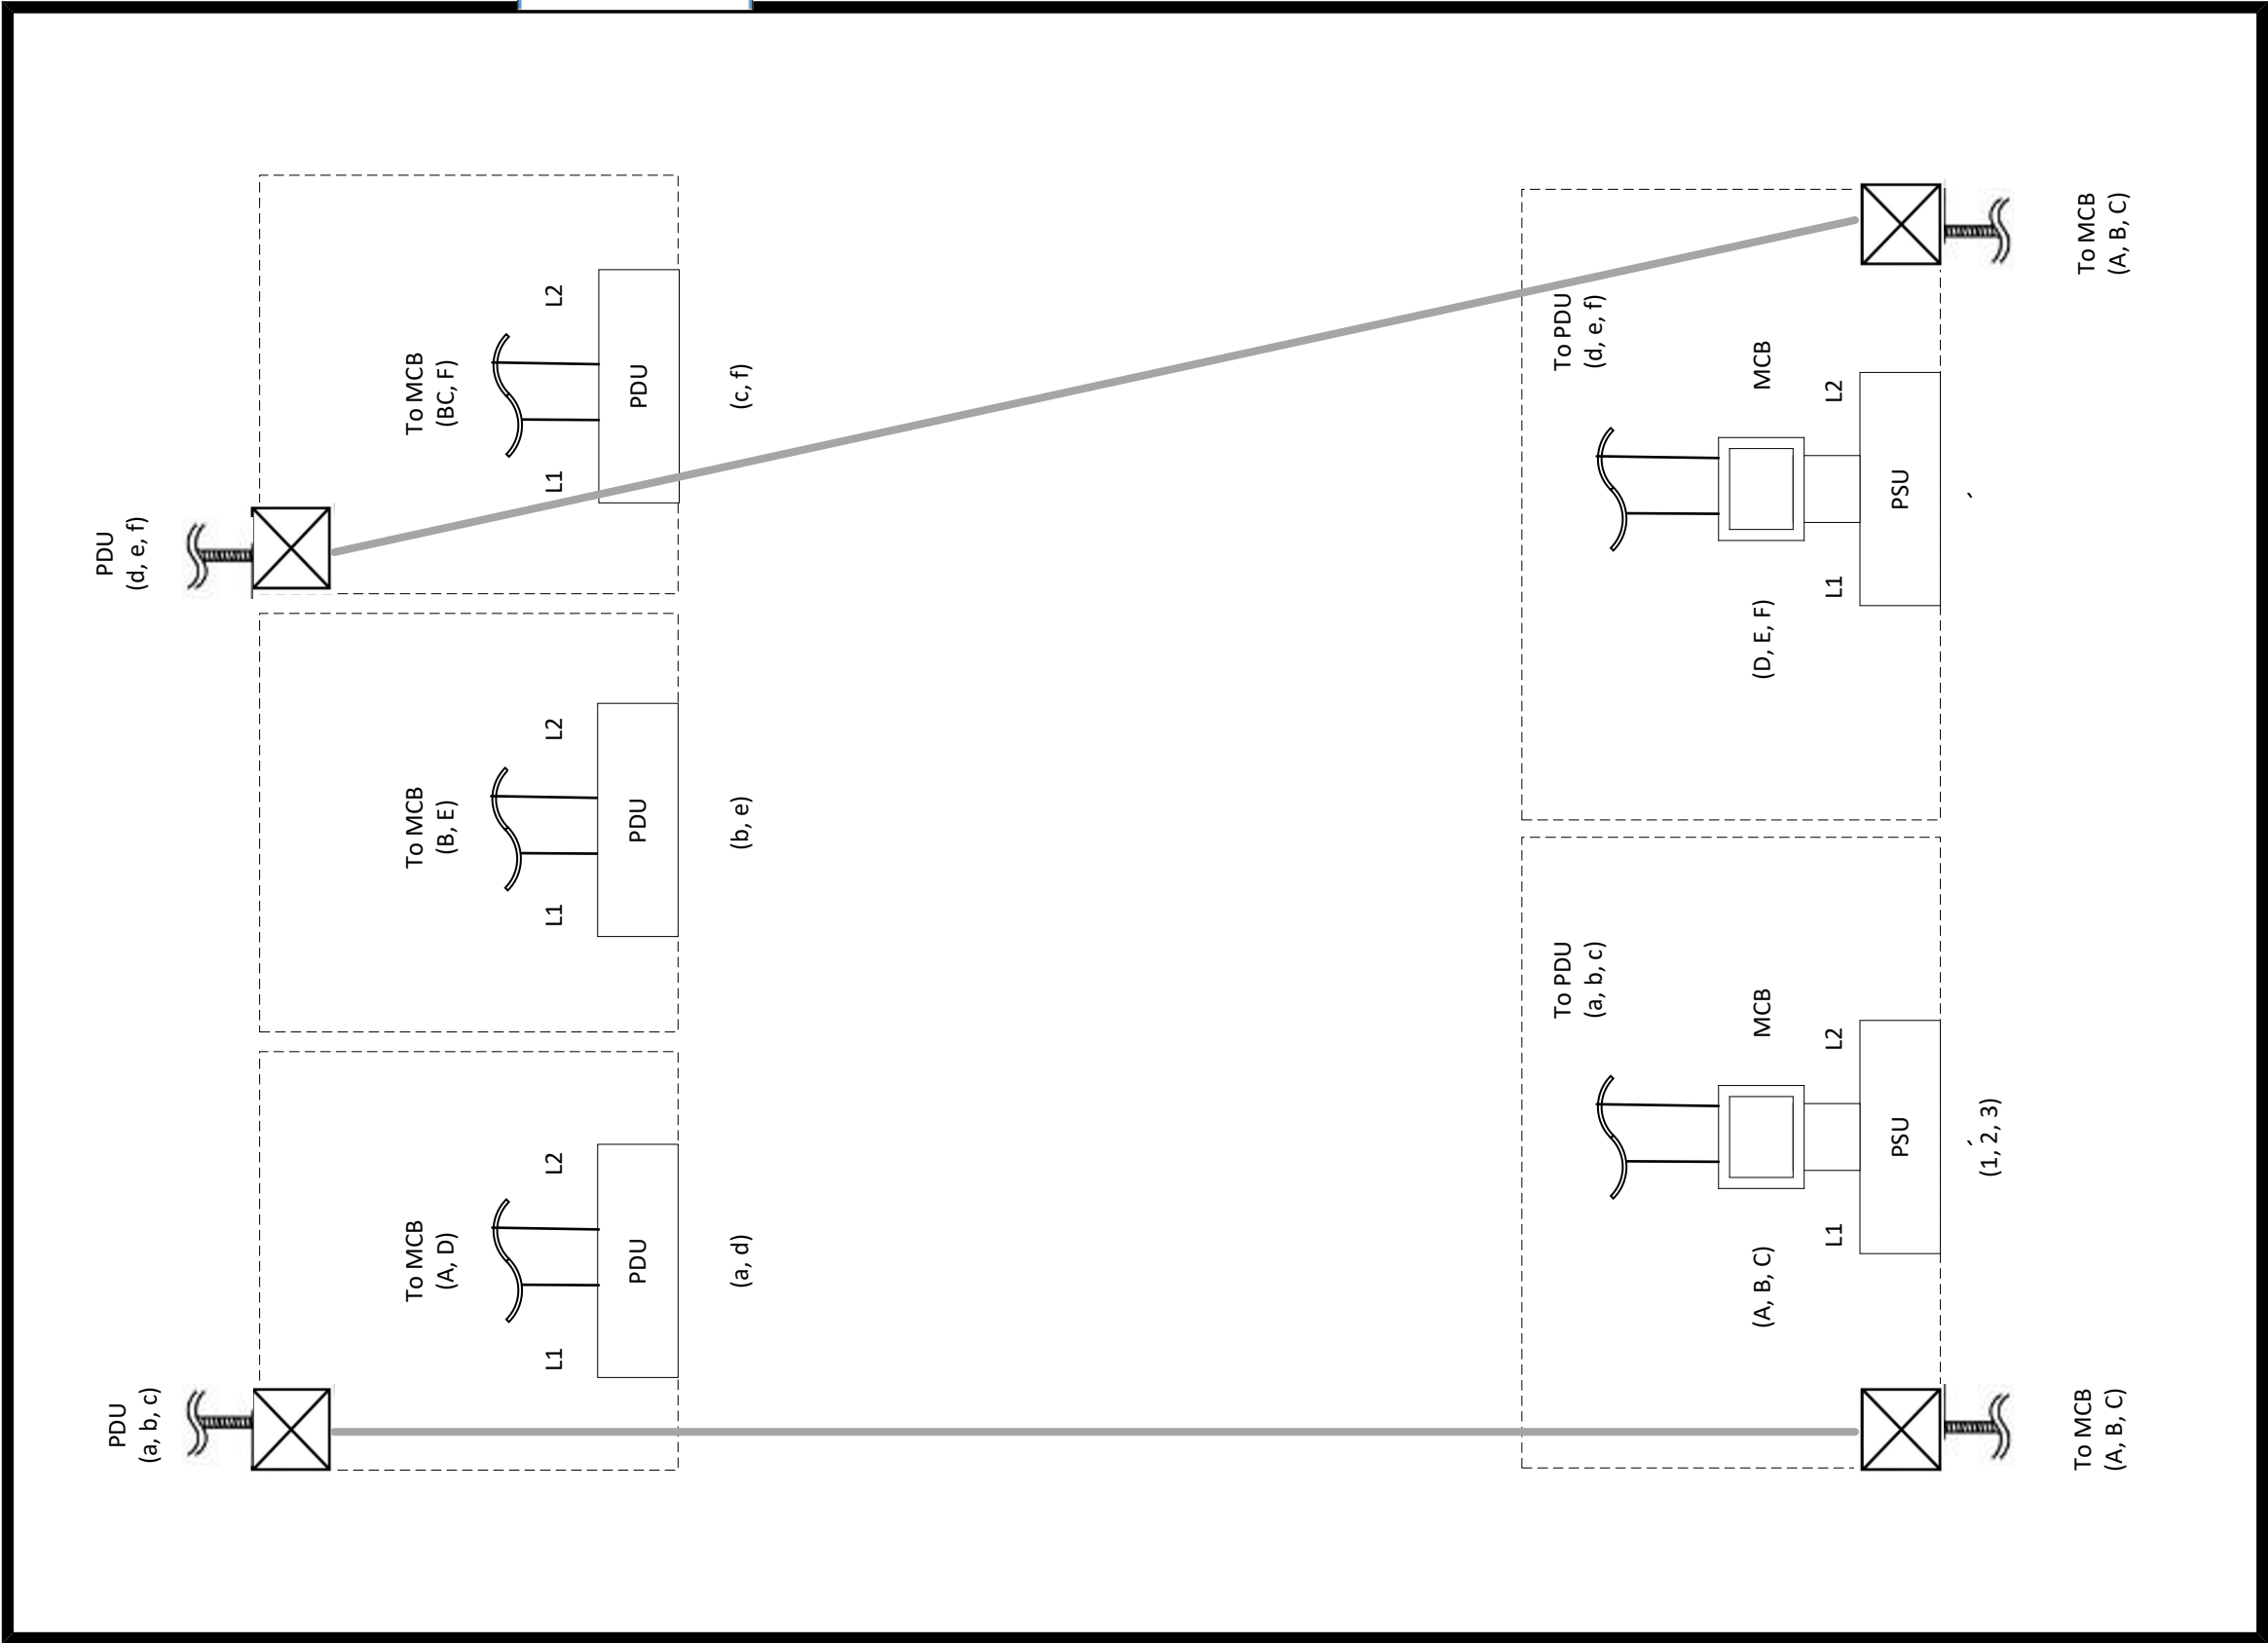

Prepared by:	Paul Lorenz Olayvar	Title:	ELECTRICAL PLAN		Date:	October 15, 2024
Checked by:	Ryan Christian Fabul	Company:	ADVANCED MEDIA BROADCASTING SYSTEM	Approved by:		Revision:

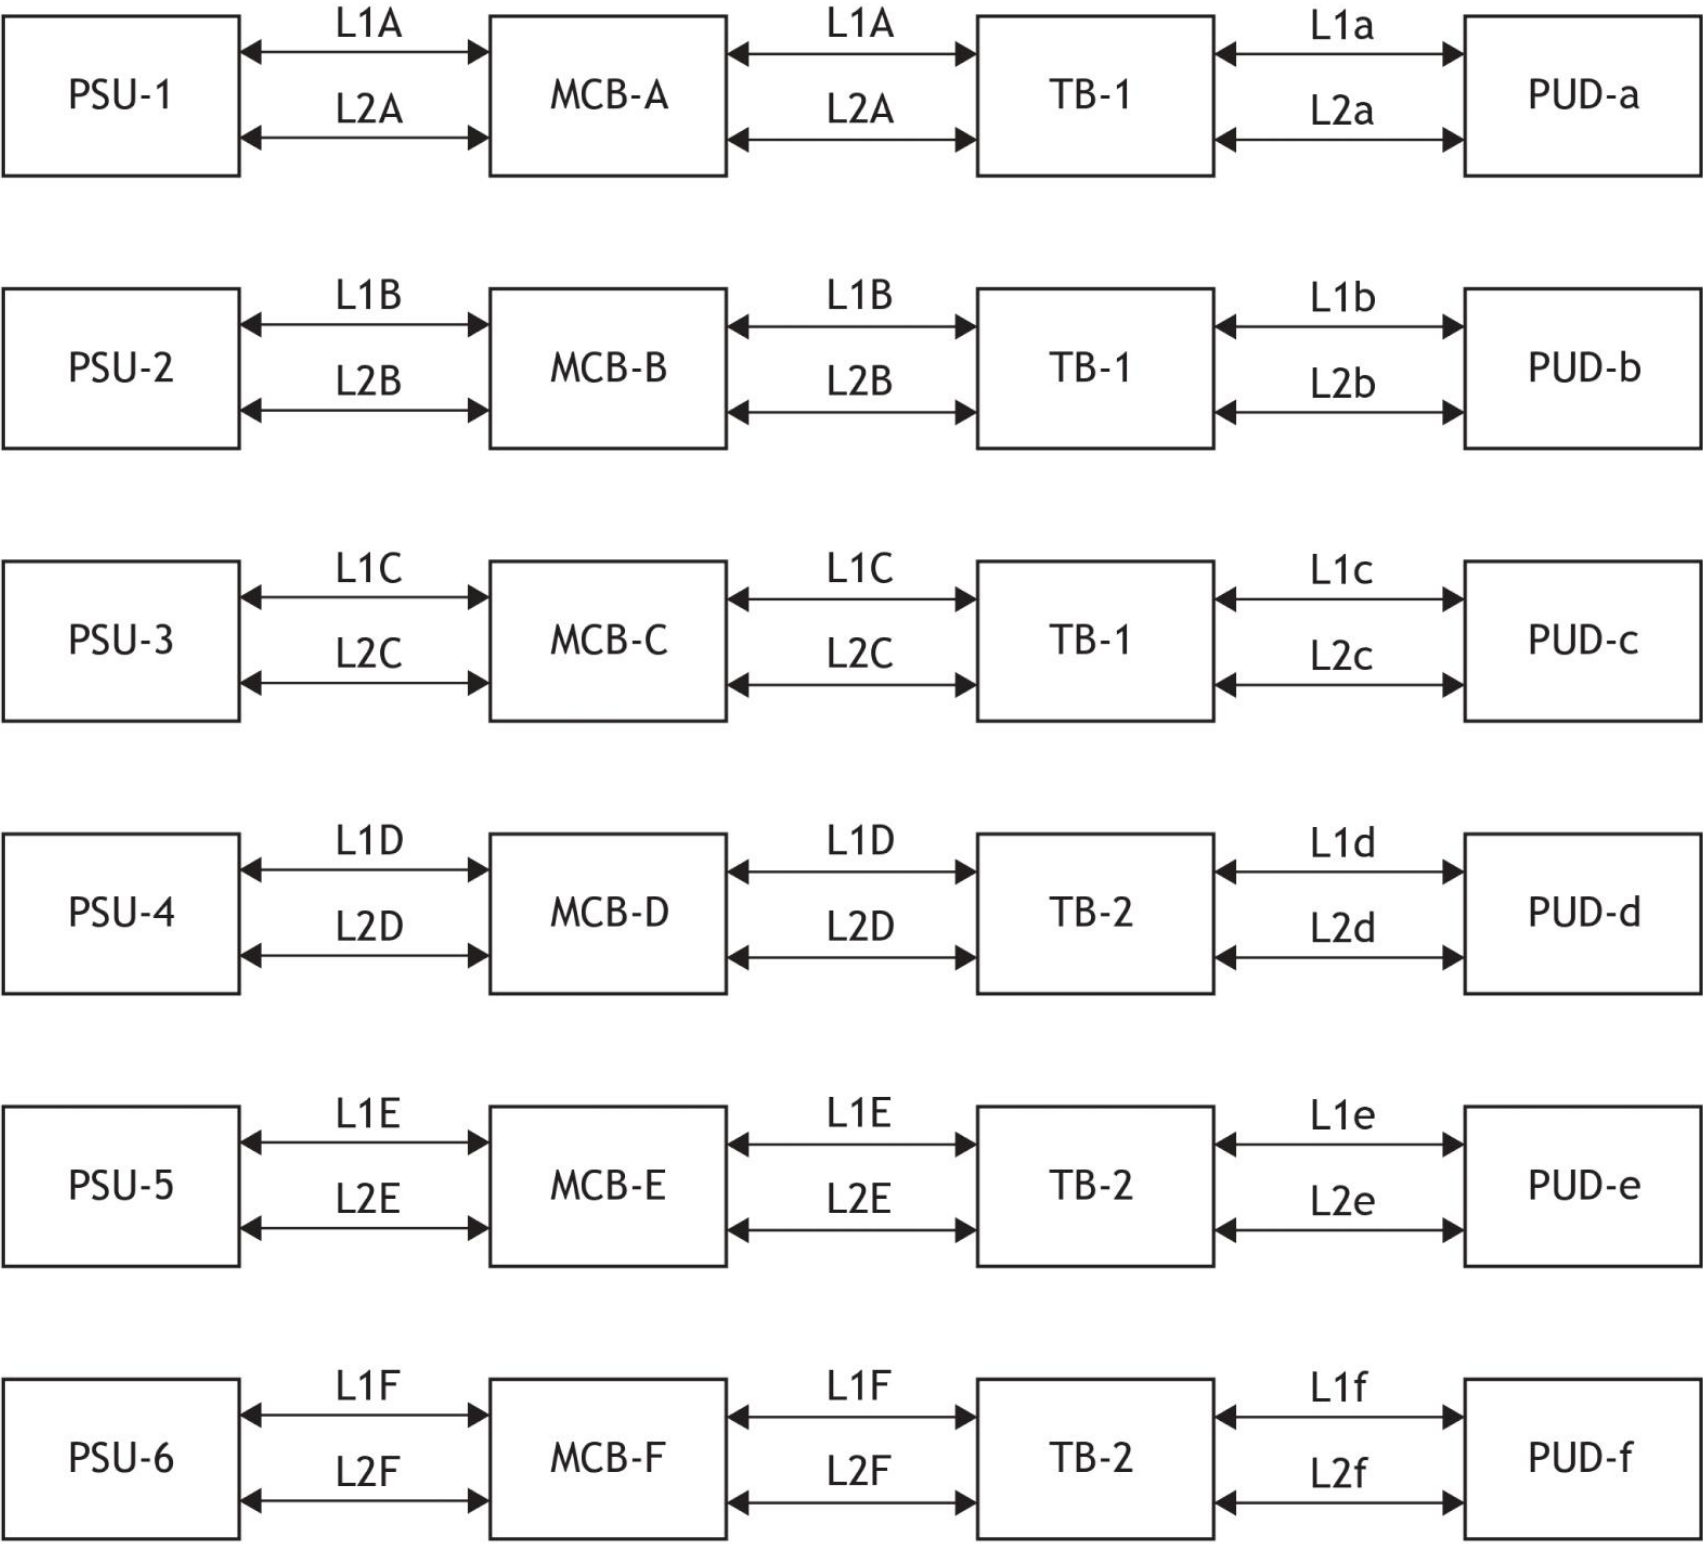

Prepared by: <b>Paul Lorenz Olayvar</b>	Title: <b>ELECTRICAL SCHEMATIC DIAGRAM</b>		Date: October 15, 2024
Checked by: <b>Ryan Christian Fabul</b>	Company: <b>ADVANCED MEDIA BROADCASTING SYSTEM</b>	Approved by:	Revision: